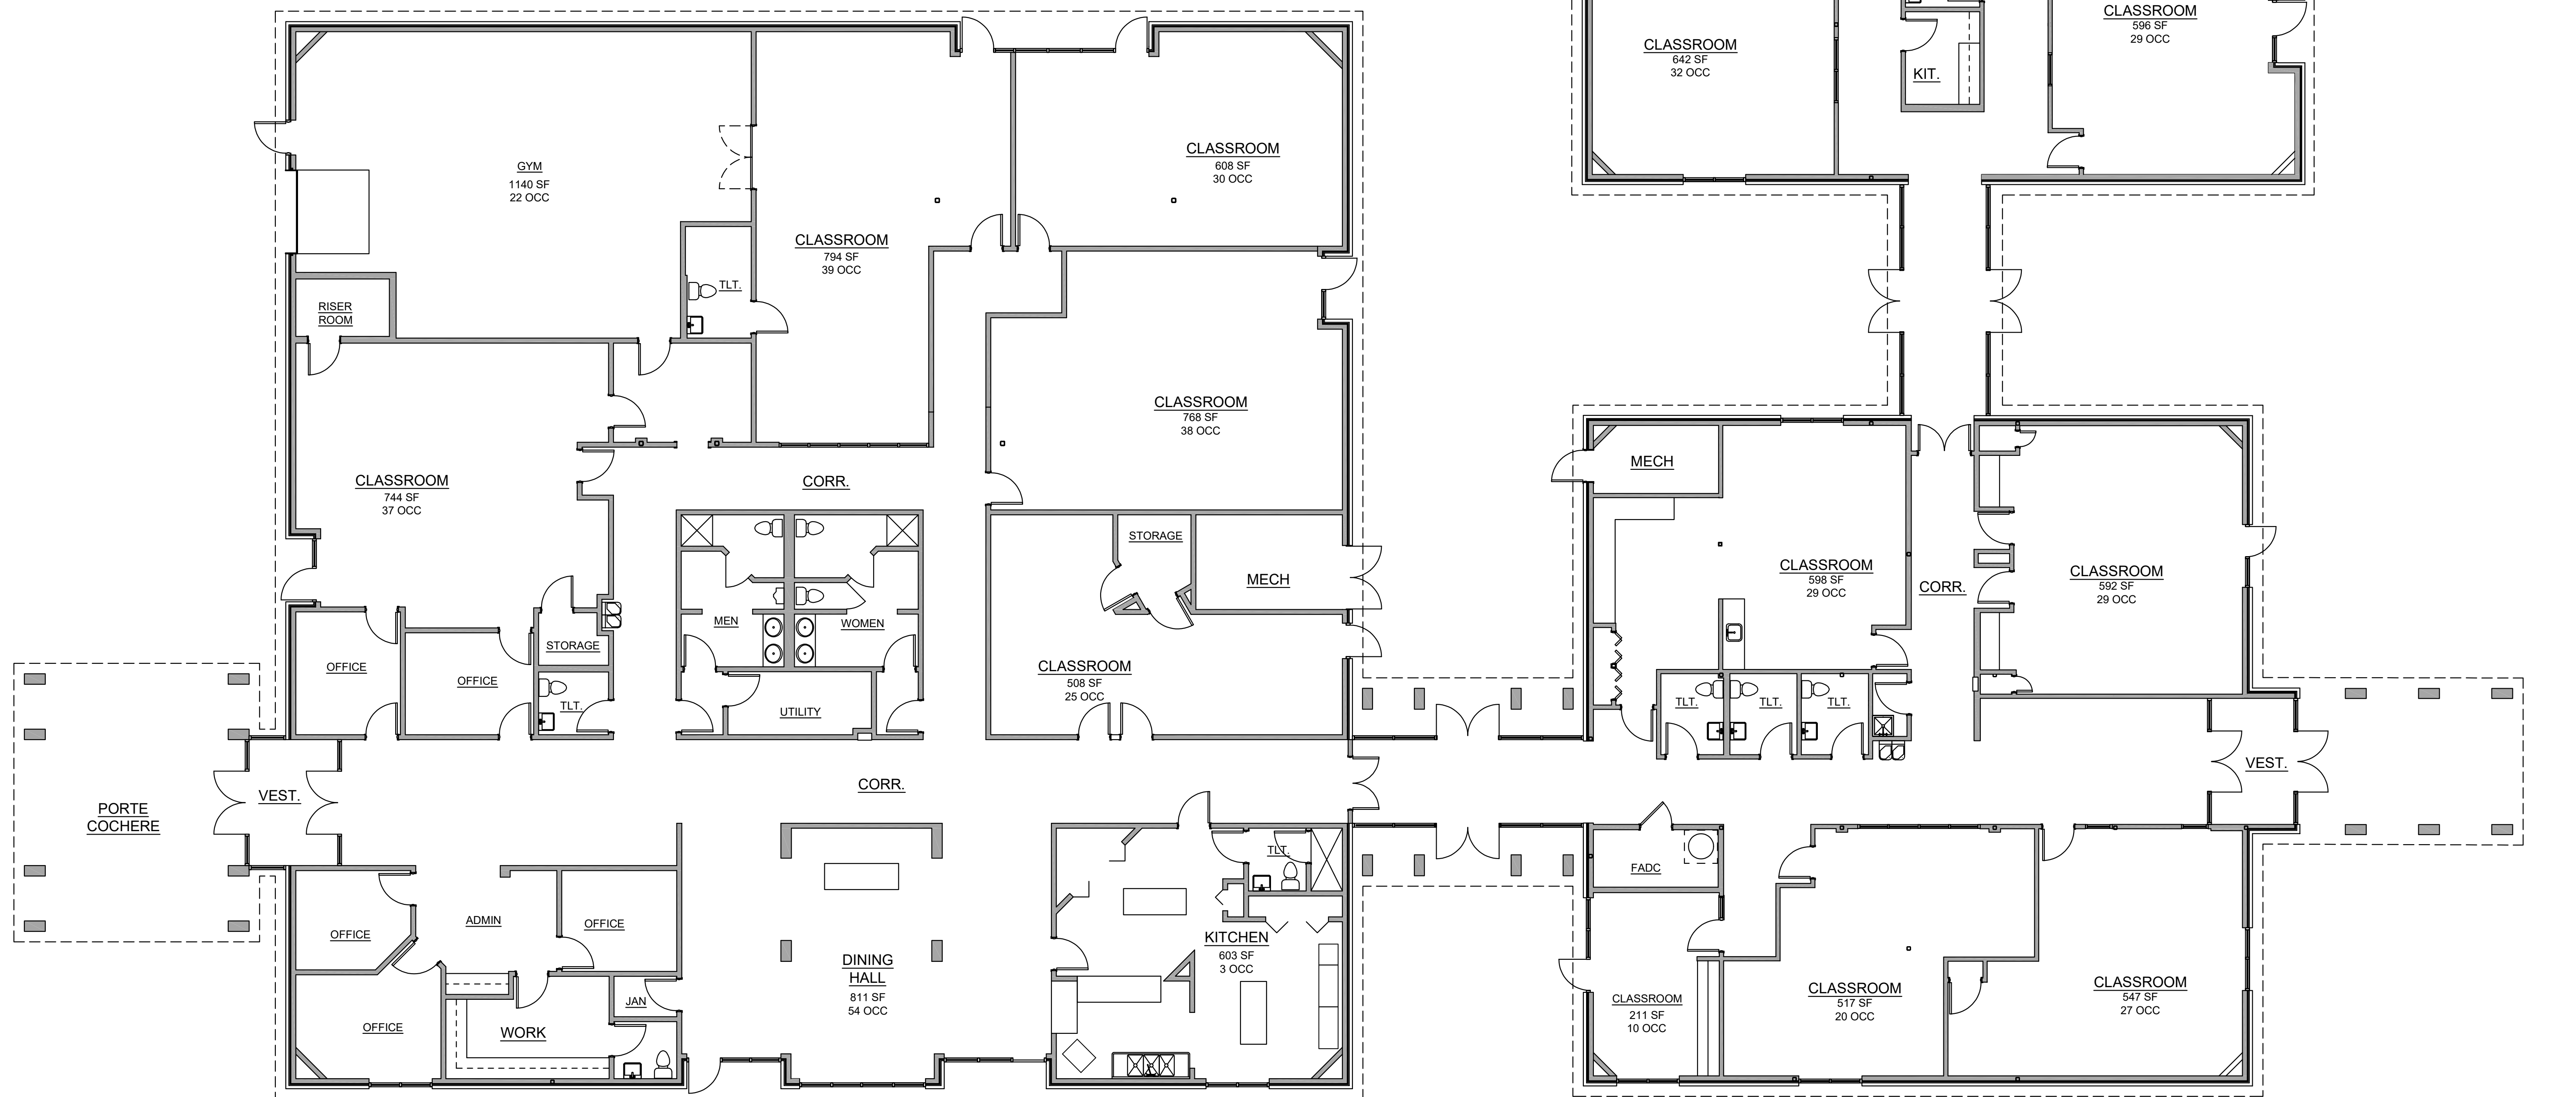


AS-BUILT
FLOOR PLAN

0 4 16 32